


A B C D E F G H I J K L M N O P

PP#9

SW-11: (18)

SW-12: 210' LF

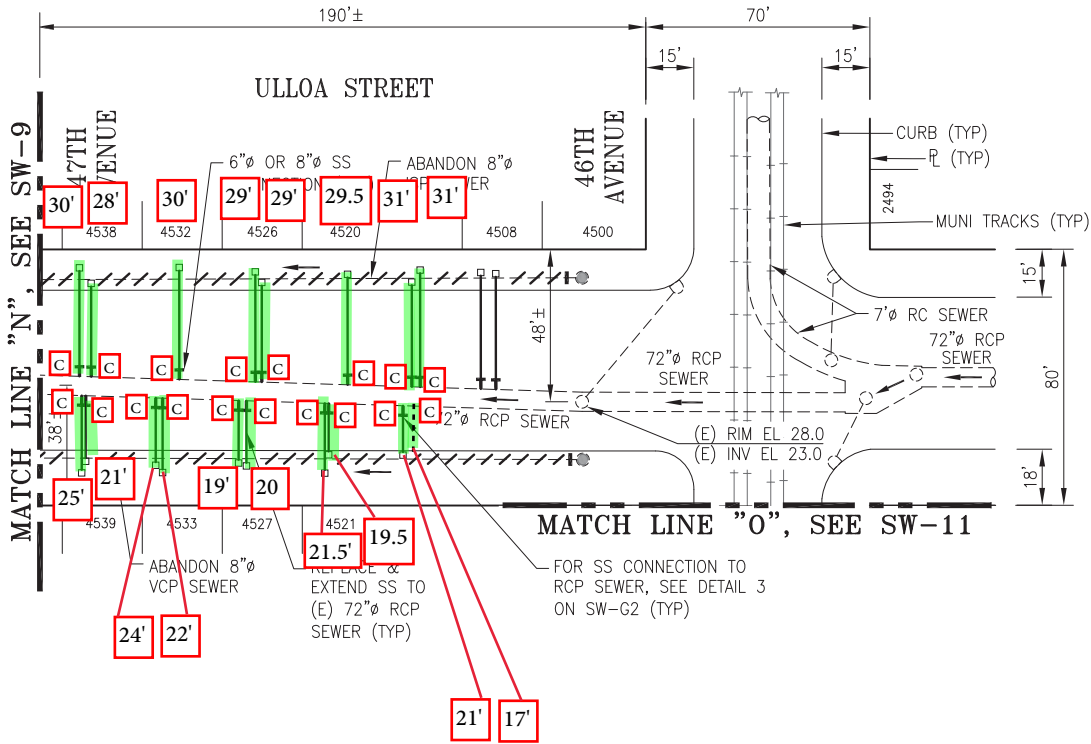

PLAN

SCALE: 1"=30'

NOTES:

- CONTRACTOR IS TO USE A WYE CONNECTION FOR SIDE SEWER LATERAL LOCATIONS ON THE SAME PROPERTY IF LATERALS ARE TOO CLOSE TO EACH OTHER TO BE REINSTATED SEPARATELY.

ELEVATION DATUM	SEWER SIZED BY D.R.
CITY	APPROVED BY N.B.



REFERENCE INFORMATION & FILE NO. OF SURVEYS

622
85380
85395
85396
A-7008
EX-5267



CITY AND COUNTY OF SAN FRANCISCO SAN FRANCISCO PUBLIC WORKS BUREAU OF ENGINEERING					
SECTION MANAGER L.WONG	05/12/2022	DRAWN AK/ V.CHEUNG	05/2022		
DEPUTY BUREAU MANAGER F.CISNEROS	06/24/2022	DESIGNED H.BAKER	05/2022		
ACTING BUREAU MANAGER I.DHAPA	07/07/2022	CHECKED C.LINH	05/2022		
NO.	DATE	DESCRIPTION	BY	APPR'D	
REVISIONS					

CONTRACT NO. WW-684 CITY AND COUNTY OF SAN FRANCISCO PUBLIC UTILITIES COMMISSION INFRASTRUCTURE DIVISION ENGINEERING MANAGEMENT BUREAU			
45TH AVE, 46TH AVE, 47TH AVE, VICENTE ST, WAWONA ST, AND SLOAT BLVD SEWER REPLACEMENT			
ULLOA STREET 47TH AVENUE TO 46TH AVENUE PLAN			
CHECKED / APPROVED	DRAWN	SCALE	
SECTION MANAGER	DESIGNED	DATE	
APPROVED	APPROVED		
MANAGER, ENGINEERING MANAGEMENT BUREAU		ASSISTANT GENERAL MANAGER WASTE WATER ENTERPRISE	
SHEET 16 OF 44	PLAN NO. SW-12	DRAWING / FILE NO. 121,463	REVISION NO. 0