

Traffic Lane Requirements
Number and Width of Lanes for Through Traffic

STREET	TIME	NORTHBOUND	SOUTHBOUND	EASTBOUND	WESTBOUND
SEWER MAIN & LATERAL WORK (OPEN TRENCH)					
47TH AVENUE					
Sloat Blvd to Wawona St (MC)	8AM-5PM (M-F) Intersection Work At Other Times	1@11' CLOSED @ Full Roadway	1@11' Full Roadway	-	-
Cross Streets for 47th Avenue					
Sloat Blvd (MC) β	8AM-5PM (M-F) At Other Times	-	-	Full Roadway	1@11' & 5' BL Full Roadway
Wawona St (east of 47th Ave) (MM) €	8AM-5PM (M-F) At Other Times	-	-	1@12' Full Roadway	1@11' Full Roadway
Wawona St (west of 47th Ave) (MM) €	8AM-5PM (M-F) At Other Times	-	-	1@11' Full Roadway	1@11' Full Roadway

☐ NO EXCEPTIONS TAKEN
☐ MAKE CORRECTIONS NOTED
☐ REJECTED
☐ REVISE AND RESUBMIT
☐ SUBMIT SPECIFIED ITEM(S)

Review is only for general conformance with the design concept of the project and general compliance with the requirements of the contract documents. Any action shown is subject to the requirements of the plans and specifications. Contractor's responsibilities include, but are not limited to actual dimensions which shall be confirmed and correlated at the job site; preferred fabrication processes and techniques of construction; coordination of the contractor's work with that of all other trades; and the satisfactory performance of the contractor's work.

Sustainable Streets Division
San Francisco Municipal Transportation Agency
City and County of San Francisco


S. Wong/S. Chan 5/13/2023
S. Wong/S. Chan 5/15/2023

CONTRACTOR SHALL NOTIFY TRAFFIC ENGINEER AT LEAST 15 WORKING DAYS IN ADVANCE OF START OF WORK, SO SFMTA CAN IMPLEMENT SIGNAL TIMING CHANGES

Traffic Lane Requirements
Number and Width of Lanes for Through Traffic

STREET	TIME	NORTHBOUND	SOUTHBOUND	EASTBOUND	WESTBOUND
SEWER LINING WORK					
47TH AVENUE					
Sloat Blvd to Wawona St	Max 72 Hours Continuous @ At Other Times	1@11' Full Roadway	1@11' Full Roadway	-	-
Wawona St to Vicente St (MC, MM) €	Max 72 Hours Continuous @ At Other Times	1@11' Full Roadway	1@11' Full Roadway	-	-
Cross Streets for 47th Ave					
Sloat Blvd (MC) β	Max 72 Hours Continuous @ At Other Times	-	-	Full Roadway	2@11' Full Roadway
Wawona St (east of 47th Ave) (MM) €	Max 72 Hours Continuous @ At Other Times	-	-	1@11' Full Roadway	-
Wawona St (west of 47th Ave)	Max 72 Hours Continuous @ At Other Times	-	-	1@10' Full Roadway	1@10' Full Roadway

PROVIDE MIN 4' WALKWAY WITH PEDESTRIAN BARRICADE ALONG WALKWAY SIDE DURING CONSTRUCTION

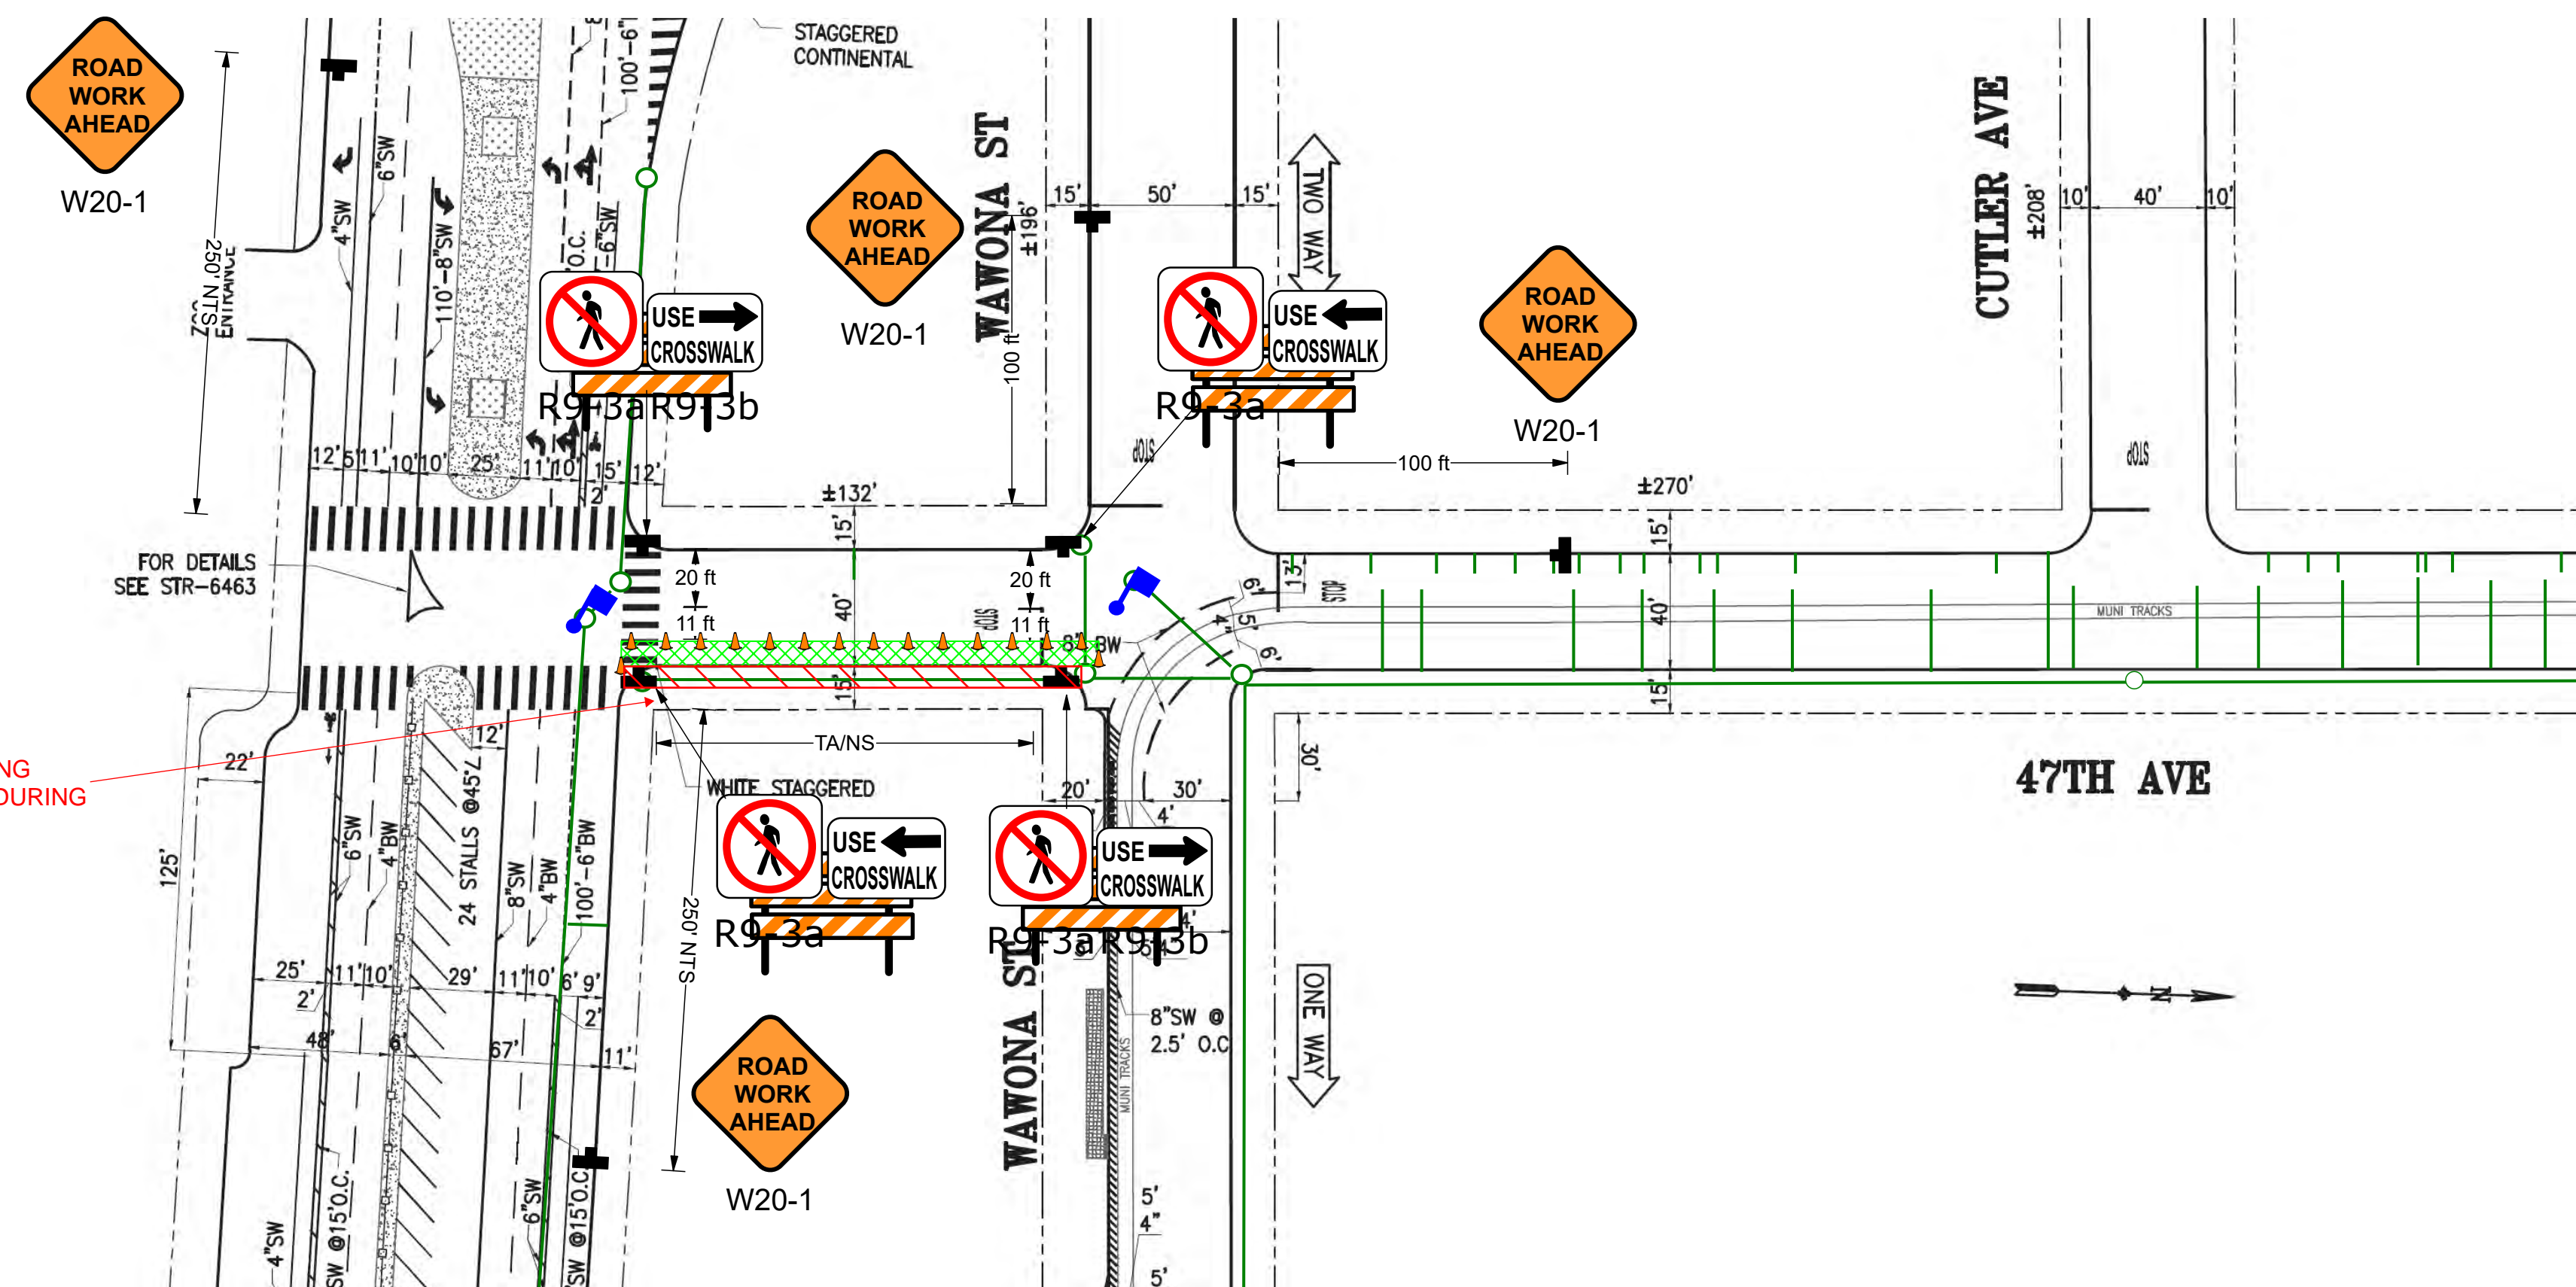

Plan Scale
1" = 50'

COMPASS		LEGEND		STAMP		GENERAL NOTES:		DR TRAFFIC CONTROL, LLC		DR TRAFFIC CONTROL		Date	03/20/2023
		 Flashing Arrow Board (Plan View) 28" Traffic Cones Temporary Delineator Type 1 Barricades Type 3 Barricades NTS: Not to Scale T/A/N/S: Tow-Away / No Stopping Flagger		 Sign and Stand Water Filled Barrier ADA Pedestrian Barrier		<p>1) CONTRACTOR TO VERIFY EXISTING STRIPING IS ACCURATE PRIOR TO START OF WORK.</p> <p>2) ALL TRAFFIC CONTROL SHALL CONFORM TO THE LATEST EDITION OF CA MUTCD.</p> <p>3) THE CONTRACTOR SHALL NOT PREVENT OR DELAY THE OPERATION OF MASS TRANSIT VEHICLES AT ANY TIME.</p> <p>4) THE CONTRACTOR SHALL PERFORM THE APPROPRIATE MEASURES TO ENSURE THE SAFETY OF BICYCLISTS ON ALL STREETS ON WHICH THERE IS CONSTRUCTION.</p>		LICENSE NO 1099211 CLASS C31 INFO@DRTRAFFICCONTROL.COM 1395 FAIRFAX AVE, UNIT A SAN FRANCISCO, CA 94124 WWW.DRTRAFFICCONTROL.COM				Author	RAMON CABRAL
												Client	PRECISION
												Location	SAN FRANCISCO
												TCP #	008
												DR Job #	0037
												Revision	000