



PROFILE - VICENTE ST

SCALE: HORIZ 1"=30'  
VERT 1"=10'

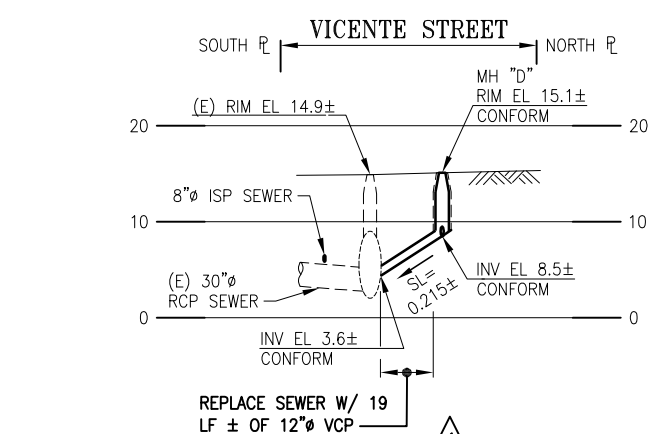


PROFILE  
47TH AVE/VICENTE ST

SCALE: HORIZ 1"=30'  
VFRT 1"=10'

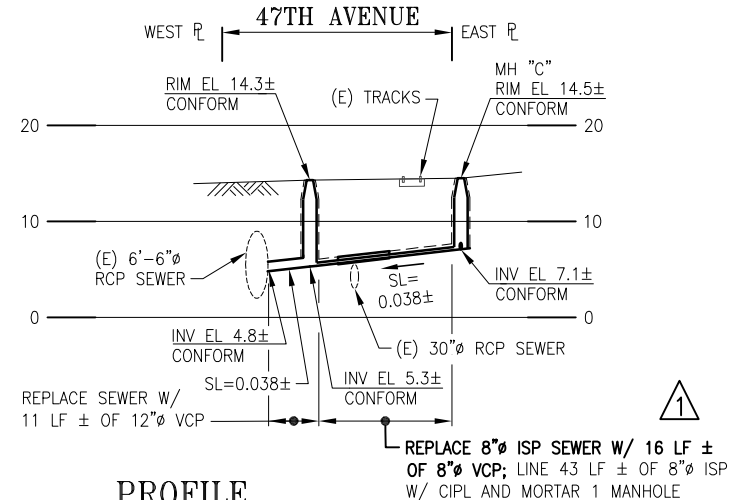


PROFILE  
 VICENTE ST/47TH AVE

SCALE: HORIZ 1"=30'  
VFRT 1"=10'

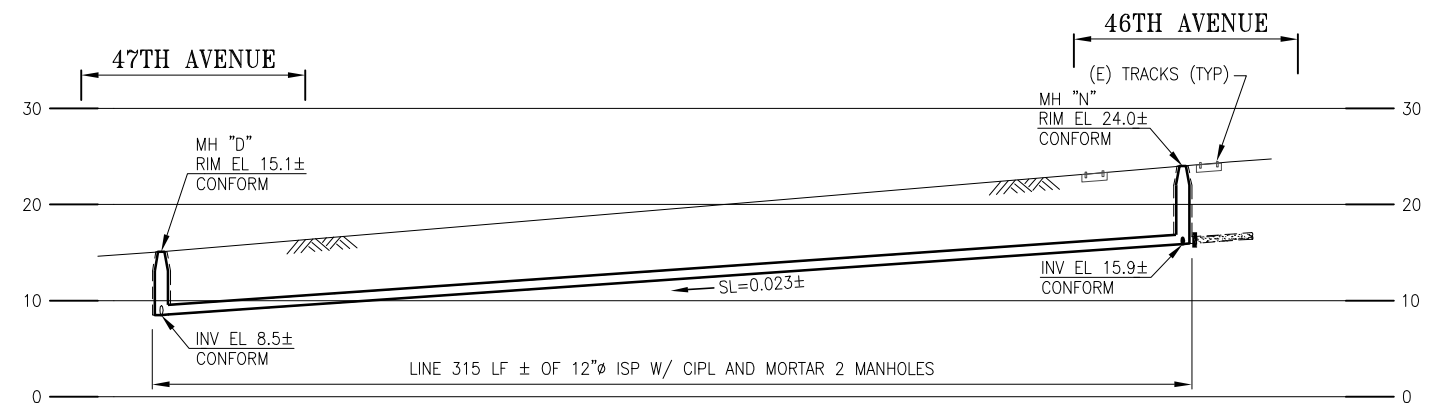

## PROFILE – VICENTE ST


SCALE: HORIZ 1"=30'  
VERT 1"=10'

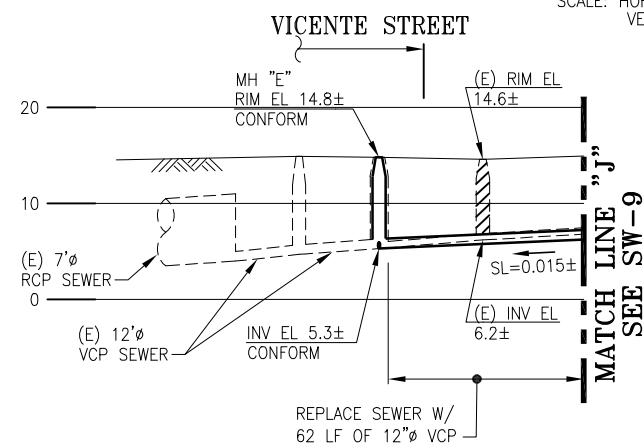

PROFILE - 47TH AVE

SCALE: HORIZ 1"=30'  
VERT 1"=10'

REFERENCE INFORMATION & FILE NO. OF SURVEYS	
612	A-15334
623	A-16942
85343.07	A-16942.1
85343.08	A-7008
85343.09	A-7014
85343.10	EX-3170
85343.11	EX-3173
85343.12	EX-3180.3

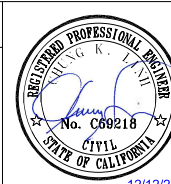

NOTES:

1. INSPECT 8" SEWER PRIOR TO ANY OTHER WORK PER BID ITEM SW-25.
2. CONTRACTOR IS TO USE A WYE CONNECTION FOR SIDE SEWER LATERAL LOCATIONS ON THE SAME PROPERTY IF LATERALS ARE TOO CLOSE TO EACH OTHER TO BE REINSTATED SEPARATELY.

SEE DWG SW-8 REV. 0  
FOR ORIGINAL SIGNATURES

CITY AND COUNTY OF SAN FRANCISCO

# SAN FRANCISCO PUBLIC WORKS

BUREAU OF ENGINEERING

CONTRACT NO. WW-684

CITY AND COUNTY OF SAN FRANCISCO  
**PUBLIC UTILITIES COMMISSION**  
INFRASTRUCTURE DIVISION  
ENGINEERING MANAGEMENT BUREAU

45TH AVE, 46TH AVE, 47TH AVE, VICENTE ST, WAWONA ST,  
AND SLOAT BLVD SEWER REPLACEMENT

VICENTE STREET  
47TH AVENUE TO 45TH AVENUE  
PLAN AND PROFILES

2	CHECKED / APPROVED	DRAWN	SCALE
2	SECTION MANAGER	DESIGNED	DATE
2	APPROVED	APPROVED	
MANAGER, ENGINEERING MANAGEMENT BUREAU		ASSISTANT GENERAL MANAGER WASTE WATER ENTERPRISE	
SHEET	PLAN NO.	DRAWING / FILE NO.	REVISION NO.
12 OF 45	SW-8	121 459	2

HYD PROJECT NO. 1070I