



PLAN
SCALE: 1"=30'

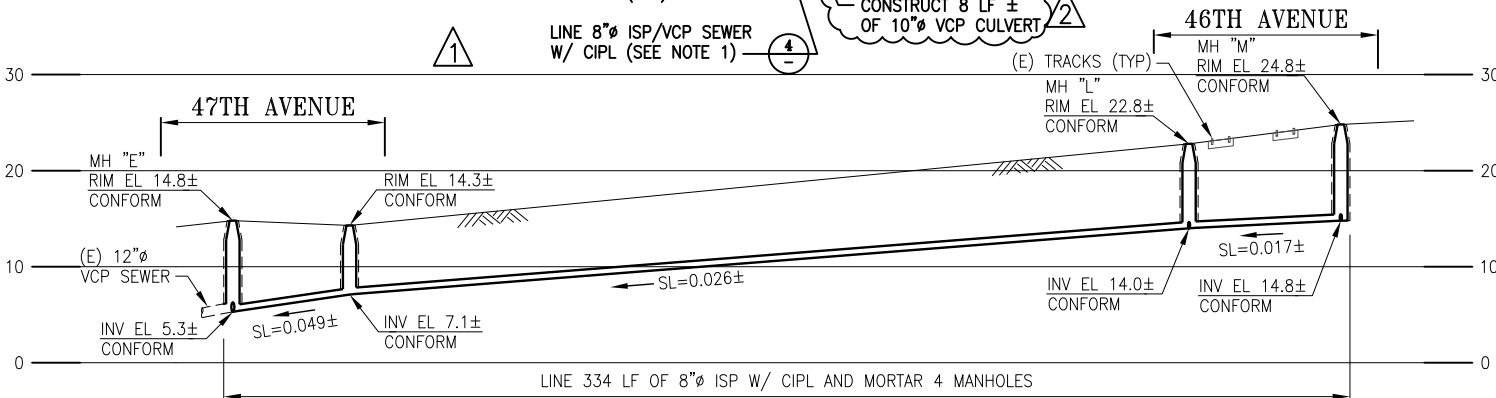


PROFILE - VICENTE ST 1

SCALE: HORIZ 1"=30'
VERT 1"=10'

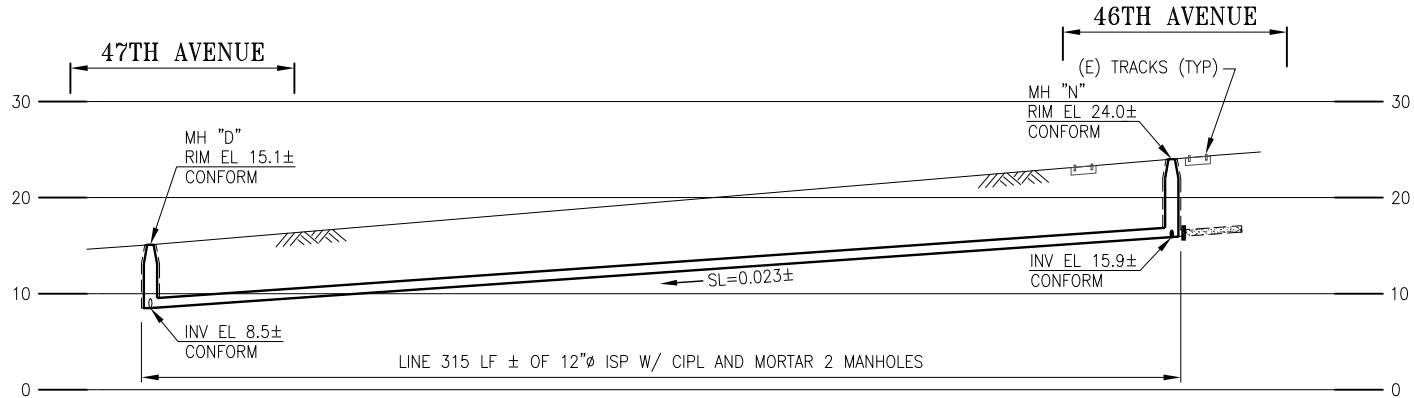


PROFILE - VICENTE ST 2

SCALE: HORIZ 1"=30'
VERT 1"=10'

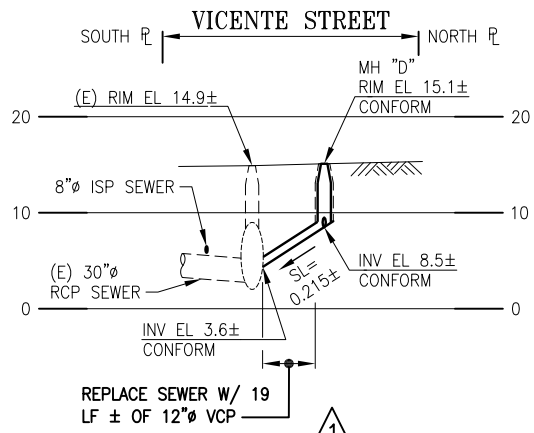


PROFILE
47TH AVE/VICENTE ST 3

SCALE: HORIZ 1"=30'
VERT 1"=10'

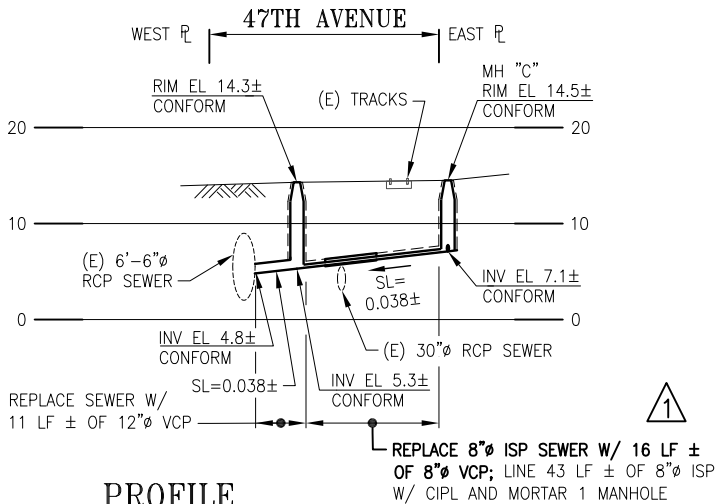

PROFILE
VICENTE ST/47TH AVE 4

SCALE: HORIZ 1"=30'
VERT 1"=10'

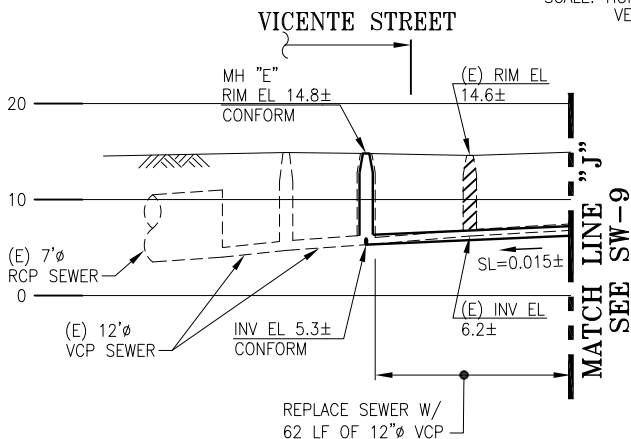

PROFILE - 47TH AVE 5

SCALE: HORIZ 1"=30'
VERT 1"=10'

NOTES:

1. INSPECT 8"Ø SEWER PRIOR TO ANY OTHER WORK PER BID ITEM SW-25.
2. CONTRACTOR IS TO USE A WYE CONNECTION FOR SIDE SEWER LATERAL LOCATIONS ON THE SAME PROPERTY IF LATERALS ARE TOO CLOSE TO EACH OTHER TO BE REINSTATED SEPARATELY.

SEE DWG SW-8 REV. 0
FOR ORIGINAL SIGNATURES

CITY AND COUNTY OF SAN FRANCISCO
SAN FRANCISCO PUBLIC WORKS
BUREAU OF ENGINEERING

SECTION MANAGER L.WONG	DESIGNED H.BAKER	05/2022
DEPUTY BUREAU MANAGER F.CISNEROS	CHECKED C.LINH	05/2022
ACTIVE BUREAU MANAGER I.DHAPA	DATE	
12/23 RECONSTRUCT CULVERT	HB	CL
07/23 SPOT SEWER REPAIR	HB	CL
DESCRIPTION	BY	APPROV
REVISIONS		

CONTRACT NO. WW-684

CITY AND COUNTY OF SAN FRANCISCO
PUBLIC UTILITIES COMMISSION
INFRASTRUCTURE DIVISION
ENGINEERING MANAGEMENT BUREAU

45TH AVE, 46TH AVE, 47TH AVE, VICENTE ST, WAWONA ST,
AND SLOAT BLVD SEWER REPLACEMENT

VICENTE STREET
47TH AVENUE TO 45TH AVENUE
PLAN AND PROFILES

CHECKED / APPROVED	DRAWN	SCALE
SECTION MANAGER	DESIGNED	DATE
APPROVED	APPROVED	
MANAGER, ENGINEERING MANAGEMENT BUREAU	ASSISTANT GENERAL MANAGER WASTE WATER ENTERPRISE	
SHEET 12 OF 45	PLAN NO. SW-8	REVISION NO. 121,459
		2

ELEVATION DATUM	SEWER SIZED BY D.R.
CITY	APPROVED BY N.B.

HORIZONTAL SCALE: 1"=30'

VERTICAL SCALE: 1"=10'