


NO EXCEPTIONS TAKEN
MAKE CORRECTIONS NOTED
REJECTED
REVISE AND RESUBMIT
SUBMIT SPECIFIED ITEM(S)

Review is only for general conformance with the design concept of the project and general compliance with the requirements of the contract documents. Any action shown is subject to the requirements of the plans and specifications. Contractor's responsibilities include, but are not limited to actual dimensions which shall be confirmed and correlated at the job site; preferred fabrication processes and techniques of construction; coordination of the contractor's work with that of all other trades; and the satisfactory performance of the contractor's work.

Sustainable Streets Division
San Francisco Municipal Transportation Agency
City and County of San Francisco

S. Wang, S. Chan 5/4/2023

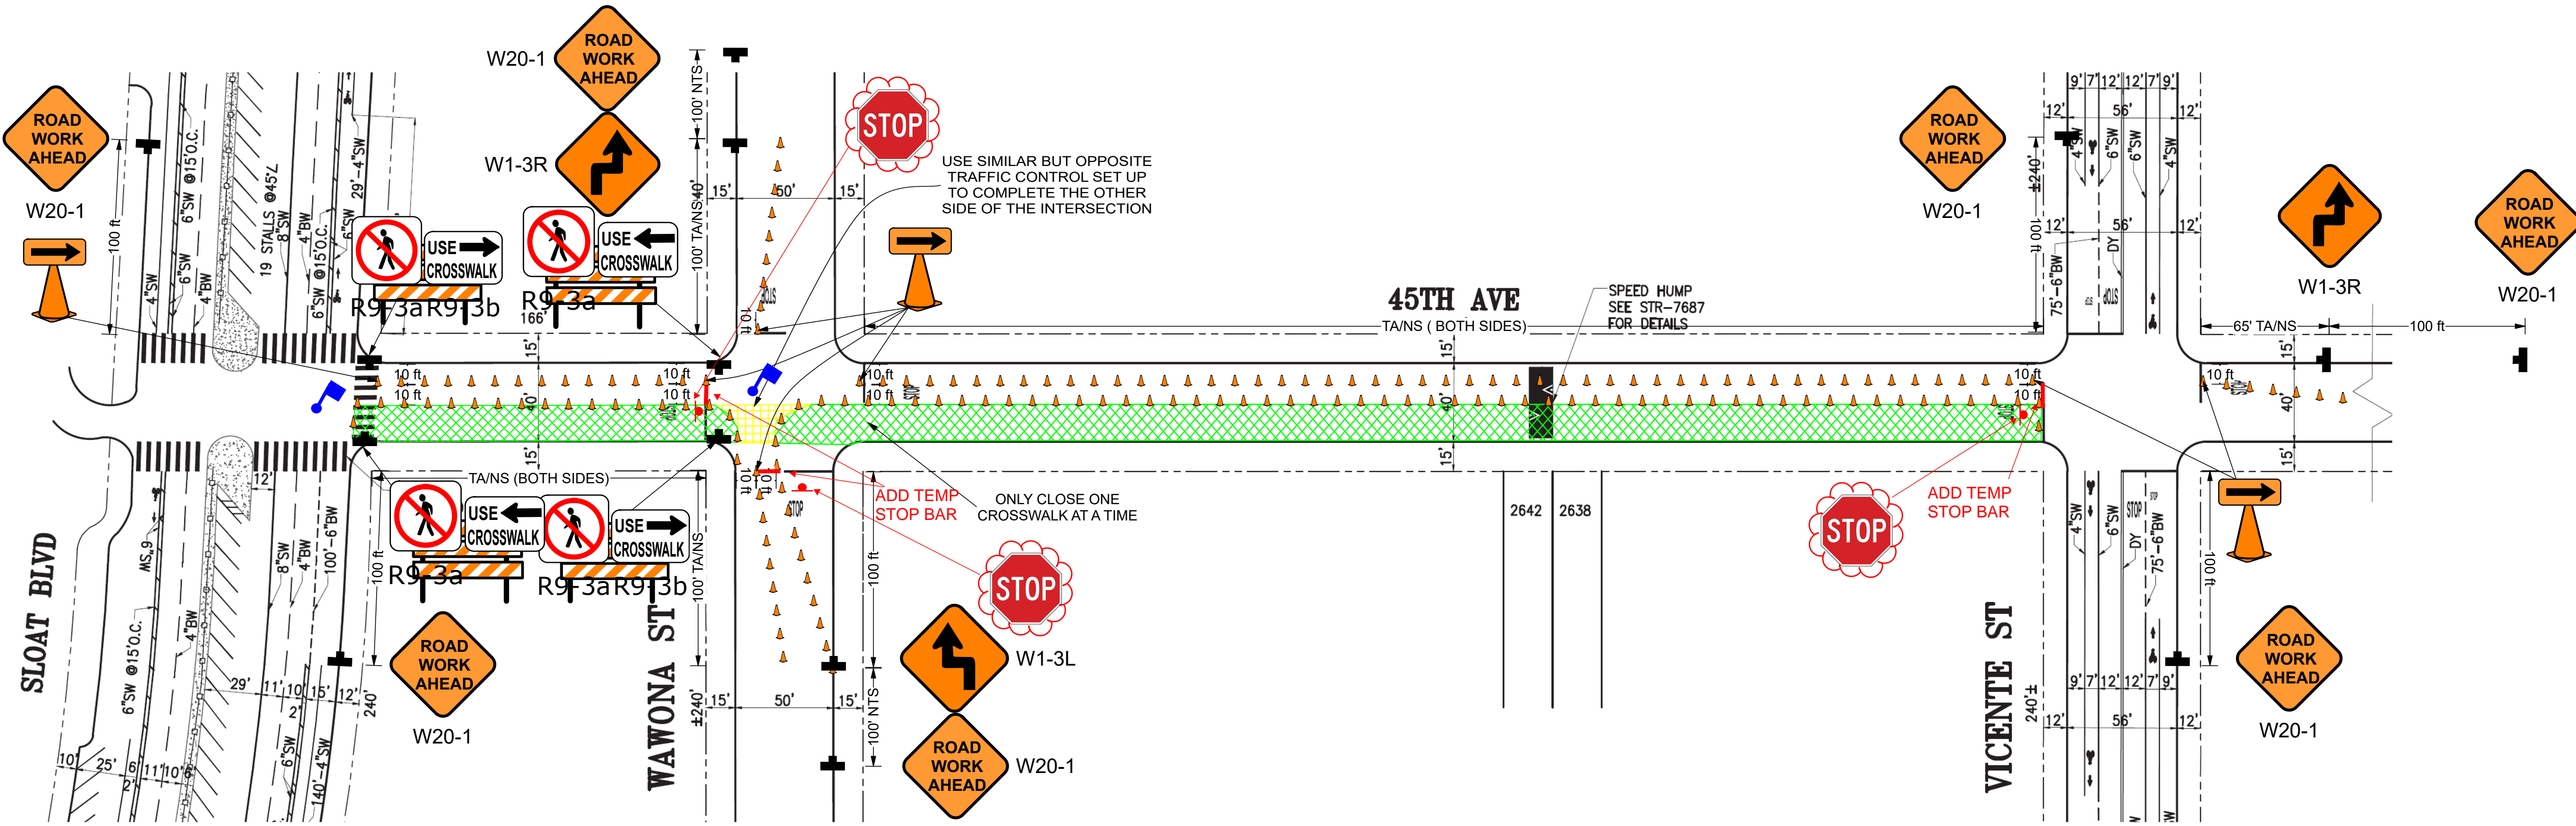

Traffic Lane Requirements Number and Width of Lanes for Through Traffic				
STREET	TIME	NORTHBOUND	SOUTHBOUND	EASTBOUND / WESTBOUND
CONCRETE BASE REPAIR, GRINDING AND PAVING, AND ALL OTHER WORK				
45TH AVENUE				
Sloat Blvd to Vicente St	BAM-SPM (M-F)	1@10'	1@10'	-
	At Other Times	Full Roadway	Full Roadway	-
Cross Streets for 45th Avenue				
Sloat Blvd (MC)	BAM-SPM (M-F)	-	-	Full Roadway / 1@11' & 5' BL
	At Other Times	-	-	Full Roadway / Full Roadway
Wawona St	BAM-SPM (M-F)	-	-	1@10' / 1@10'
	At Other Times	-	-	Full Roadway / Full Roadway
Vicente St	At All Times	-	-	Full Roadway / Full Roadway

Plan Scale
1" = 50'

COMPASS

LEGEND

	Flashing Arrow Board		Work Area
	Flashing Arrow Board (Plan View)		Sign and Stand
	28" Traffic Cones		Water Filled Barrier
	Temporary Delineator		ADA Pedestrian Barrier
	Type 1 Barricades		
	Type 3 Barricades		
	NTS		Not to Scale
	T/A/N/S		Tow-Away / No Stopping
	Flagger		

STAMP

TRAFFIC CONTROL PLAN

WW-684 - 45TH AVE, 46TH AVE, 47TH AVE,
VICENTE ST, WAWONA ST, AND SLOAT BLVD
Base repair, Grinding & Paving -
45TH AVE FROM SLOAT BLVD TO VICENTE ST

- GENERAL NOTES:
- CONTRACTOR TO VERIFY EXISTING STRIPING IS ACCURATE PRIOR TO START OF WORK.
 - ALL TRAFFIC CONTROL SHALL CONFORM TO THE LATEST EDITION OF CA MUTCD.
 - THE CONTRACTOR SHALL NOT PREVENT OR DELAY THE OPERATION OF MASS TRANSIT VEHICLES AT ANY TIME.
 - THE CONTRACTOR SHALL PERFORM THE APPROPRIATE MEASURES TO ENSURE THE SAFETY OF BICYCLISTS ON ALL STREETS ON WHICH THERE IS CONSTRUCTION.

DR TRAFFIC CONTROL, LLC

LICENSE NO 1099211
CLASS C31

INFO@DRTRAFFICCONTROL.COM

1395 FAIRFAX AVE, UNIT A
SAN FRANCISCO, CA 94124
WWW.DRTRAFFICCONTROL.COM

TRAFFIC CONTROL

Date	03/23/2023
Author	DEREK DOAN
Client	PRECISION
Location	SAN FRANCISCO
TCP #	027
DR Job #	0037
Revision	000