
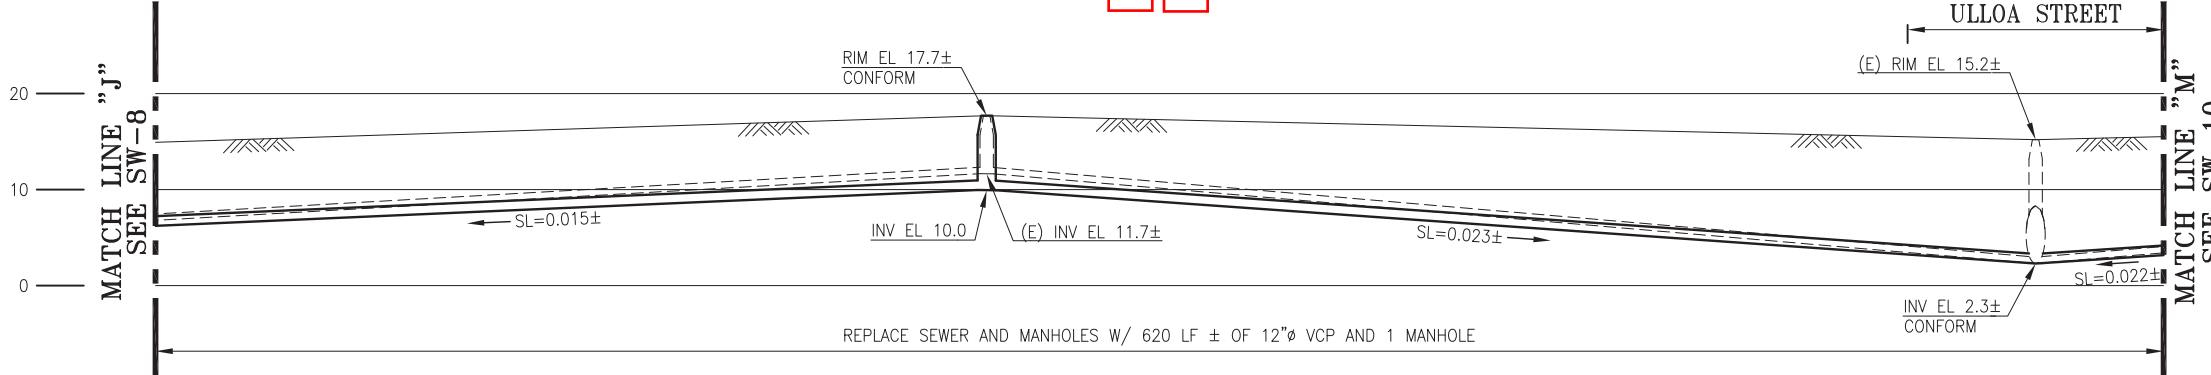


PP#9

SW-10: (49)
SW-11: (2)
SW-12: 923 ' LF

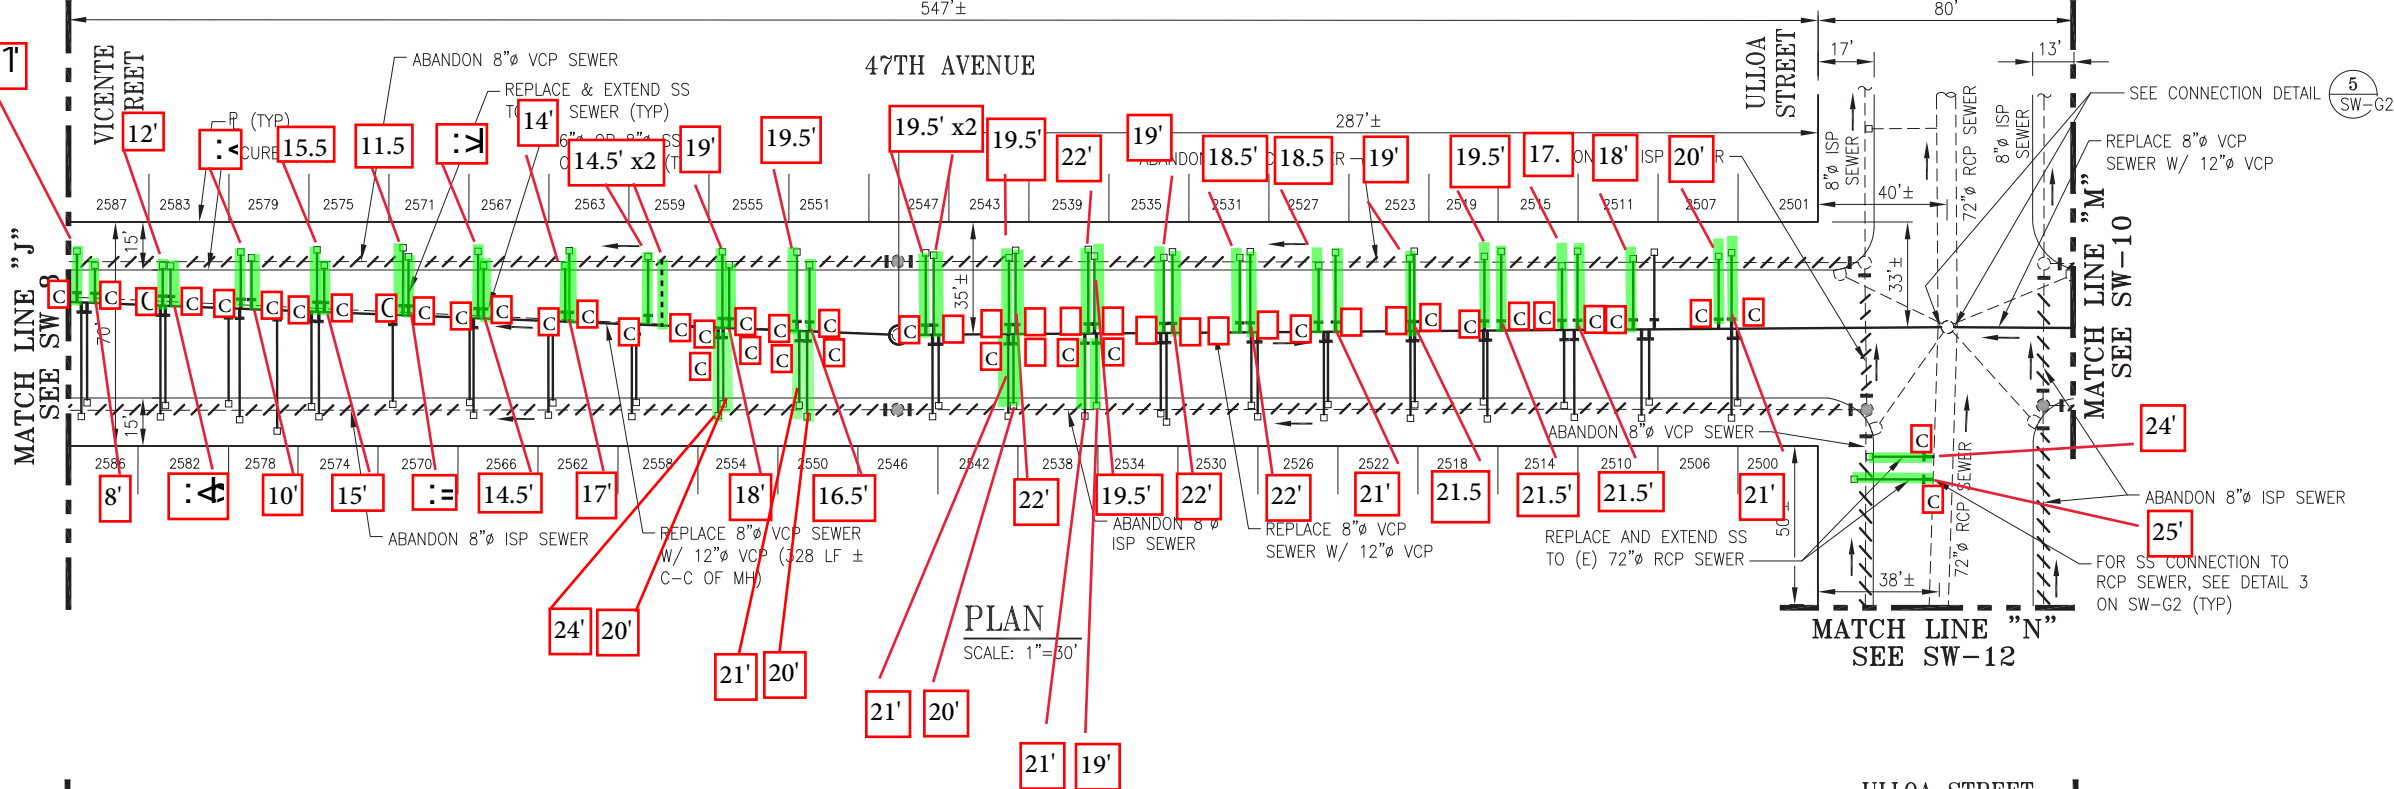


PROFILE - 47TH AVE

SCALE: HORIZ 1"=30'
VERT 1"=10'


NOTES:

1. CONTRACTOR IS TO USE A WYE CONNECTION FOR SIDE SEWER LATERAL LOCATIONS ON THE SAME PROPERTY IF LATERALS ARE TOO CLOSE TO EACH OTHER TO BE REINSTATED SEPARATELY.
2. 5 WORKING DAYS PRIOR TO MOBILIZATION FOR SEWER WORK, VERIFY INVERT ELEVATION AT 72" RCP AND 12" VCP SEWER. PROVIDE THE CITY REPRESENTATIVE WITH THE INVERT ELEVATIONS.

ELEVATION DATUM	SEWER SIZED BY D.R.
CITY	APPROVED BY N.R.

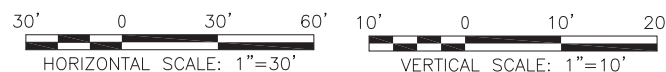

REFERENCE INFORMATION & FILE NO. OF SURVEYS
A-14529-1 A-7008 EX-5596 L-7131 P-254

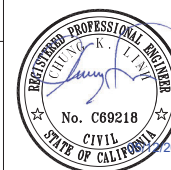

CITY AND COUNTY OF SAN FRANCISCO <h1 style="margin: 0;">SAN FRANCISCO PUBLIC WORKS</h1> BUREAU OF ENGINEERING				
SECTION MANAGER L.WONG <i>L Wong</i> 05/12/2022 SENIOR BUREAU MANAGER F.CISNEROS <i>F C</i> 06/24/2022 ACTIONING BUREAU MANAGER I.DHAPA <i>I Dhapa</i> 07/07/2022	DRAWN AK / V.CHEUNG 05/20/22 REVISOR H.BAKER 05/20/22 CHECKED C.LINH 05/20/22			
NO.	DATE	DESCRIPTION	BY	APPROV
REVISIONS				

<p align="center">CONTRACT NO. WW-684</p> <p align="center">CITY AND COUNTY OF SAN FRANCISCO</p> <p align="center">PUBLIC UTILITIES COMMISSION</p> <p align="center">INFRASTRUCTURE DIVISION</p> <p align="center">ENGINEERING MANAGEMENT BUREAU</p>			
<p align="center">45TH AVE, 46TH AVE, 47TH AVE, VICENTE ST, WAWONA ST, AND SLOAT BLVD SEWER REPLACEMENT</p> <p align="center">47TH AVENUE</p> <p align="center">VICENTE STREET TO ULLOA STREET</p> <p align="center">PLAN AND PROFILE</p>			
22	CHECKED / APPROVED	DRAWN	SCALE
22	SECTION MANAGER	DESIGNED	DATE
22	APPROVED	APPROVED	
MANAGER, ENGINEERING MANAGEMENT BUREAU		ASSISTANT GENERAL MANAGER WASTE WATER ENTERPRISE	
06	SHEET 13 OF 44	PLAN NO. SW-9	DRAWING / FILE NO. 121.460
			REVISION NO. 0