

SW-33

FOR SS CONNECTION TO
RCP SEWER, SEE DETAIL 3
ON SW-G2 (TYP)
REPLACE & EXTEND
SS TO (E) 30"Ø
RCP SEWER (TYP)

MATCH LINE "D"
SEE SW-5

LINE 8"Ø VCP SEWER
W/ CIPL (SEE NOTE 1) ④
REINSTATE (E) 6"Ø OR 8"Ø
SS CONNECTION TO NEWLY
LINED MAIN SEWER (TYP)

WAWONA STREET

LINE 8"Ø ISP SEWER W/ CIPL
(314 LF ± C-C OF MH) ⑤


MATCH LINE "E"
SEE SW-6

LINE 8"Ø ISP SEWER
W/ CIPL (SEE NOTE 1) ①
LINE 8"Ø ISP
SEWER W/ CIPL ⑦

MATCHLINE "F"
SEE SW-4


PLAN
SCALE: 1"=30'

MATCH LINE "C", SEE SW-1

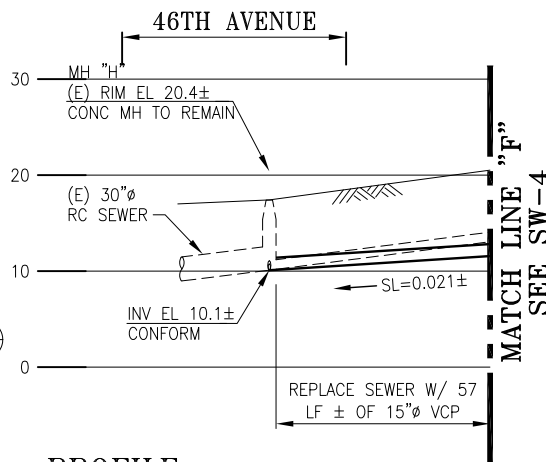


PROFILE
WAWONA ST & 46TH AVE ③

SCALE: HORIZ 1"=30'
VERT 1"=10'

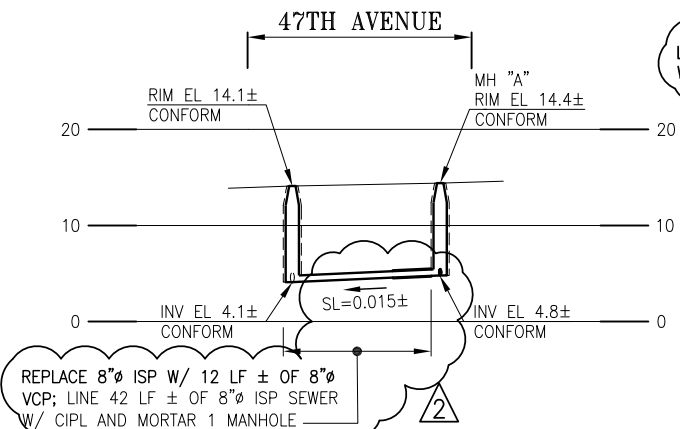


PROFILE - WAWONA ST & 47TH AVE ②

SCALE: HORIZ 1"=30'
VERT 1"=10'

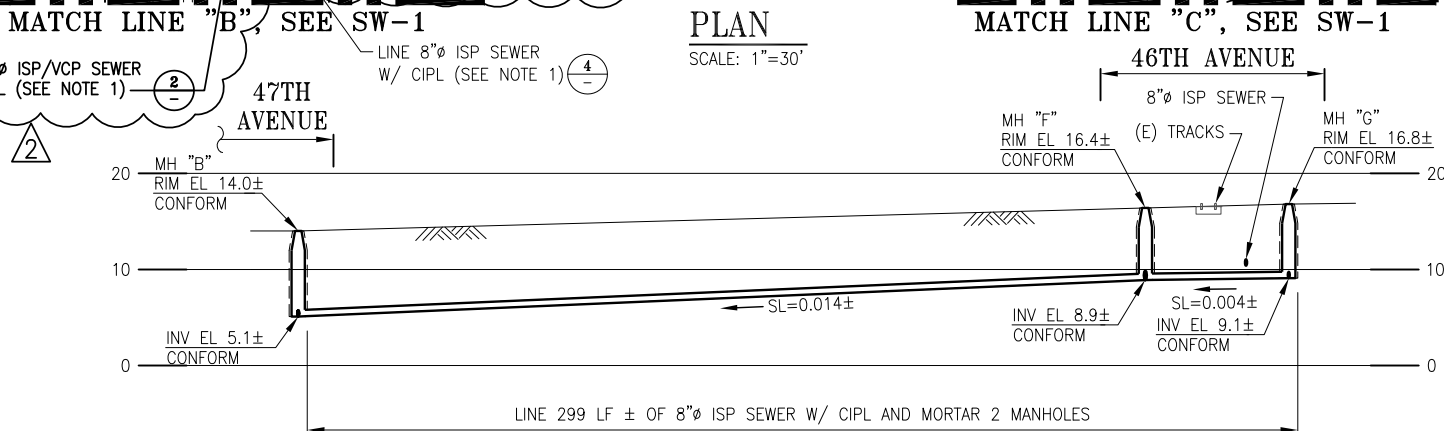


PROFILE - WAWONA STREET ①

SCALE: HORIZ 1"=30'
VERT 1"=10'

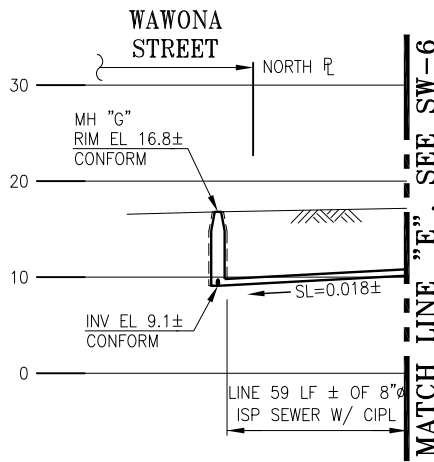


PROFILE - 46TH AVE
(EAST ALIGNMENT) ⑦

SCALE: HORIZ 1"=30'
VERT 1"=10'

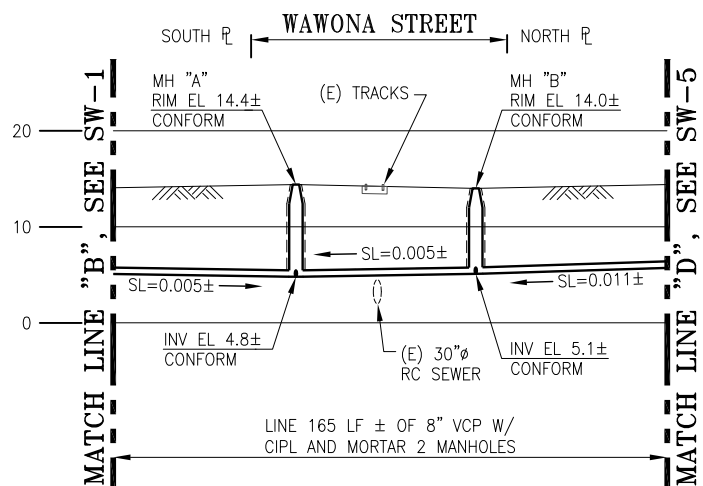


PROFILE - 47TH AVE ④

SCALE: HORIZ 1"=30'
VERT 1"=10'

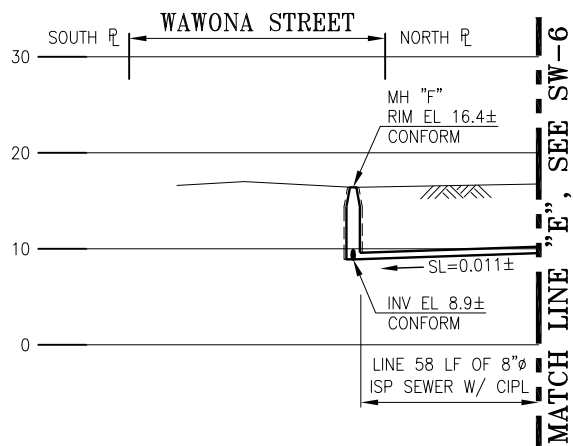

PROFILE - 46TH AVE
(WEST ALIGNMENT) ⑤

SCALE: HORIZ 1"=30'
VERT 1"=10'

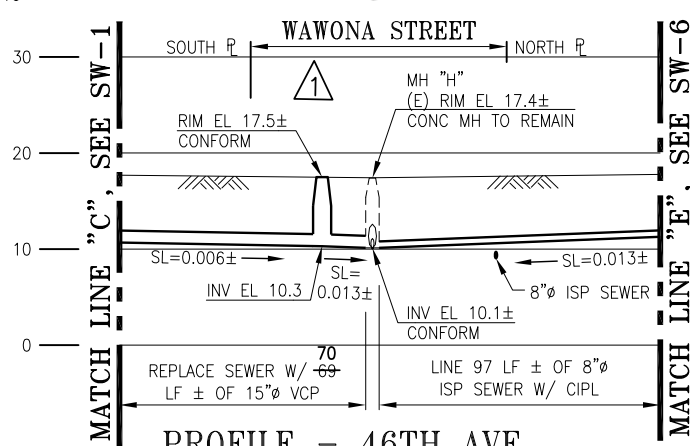

PROFILE - 46TH AVE
(CENTER ALIGNMENT) ⑥

SCALE: HORIZ 1"=30'
VERT 1"=10'

NOTES:

1. INSPECT 8"Ø SEWER PRIOR TO ANY OTHER
WORK PER BID ITEM SW-25.
2. CONTRACTOR IS TO USE A WYE CONNECTION FOR
SIDE SEWER LATERAL LOCATIONS ON
THE SAME PROPERTY IF LATERALS ARE TOO
CLOSE TO EACH OTHER TO BE REINSTATED
SEPARATELY.

REFERENCE INFORMATION
& FILE NO. OF SURVEYS
623
624
A-7008
EX-3115
EX-3180.4



SEE DWG SW-3 REV. 0
FOR ORIGINAL SIGNATURES

CITY AND COUNTY OF SAN FRANCISCO
SAN FRANCISCO PUBLIC WORKS
BUREAU OF ENGINEERING

SECTION MANAGER L. WONG	DESIGNED H. BAKER	05/2022
DEPUTY BUREAU MANAGER F. CISNEROS	CHECKED C. LINH	05/2022
ACTING BUREAU MANAGER I. DHAPA	DATE	DESCRIPTION
07/23	SPOT SEWER REPAIR	HB CL
07/23	RELOCATE NEW SEWER & MHS	HB CL

CONTRACT NO. WW-684

CITY AND COUNTY OF SAN FRANCISCO
PUBLIC UTILITIES COMMISSION
INFRASTRUCTURE DIVISION
ENGINEERING MANAGEMENT BUREAU

45TH AVE, 46TH AVE, 47TH AVE, VICENTE ST, WAWONA ST,
AND SLOAT BLVD SEWER REPLACEMENT
WAWONA STREET
47TH AVENUE TO 46TH AVENUE
PLAN AND PROFILES

CHECKED / APPROVED	DRAWN	SCALE
SECTION MANAGER	DESIGNED	DATE
APPROVED	APPROVED	
MANAGER, ENGINEERING MANAGEMENT BUREAU	ASSISTANT GENERAL MANAGER WASTE WATER ENTERPRISE	
SHEET 7 OF 45	PLAN NO. SW-3	DRAWING / FILE NO. 121,454
		REVISION NO. 2