
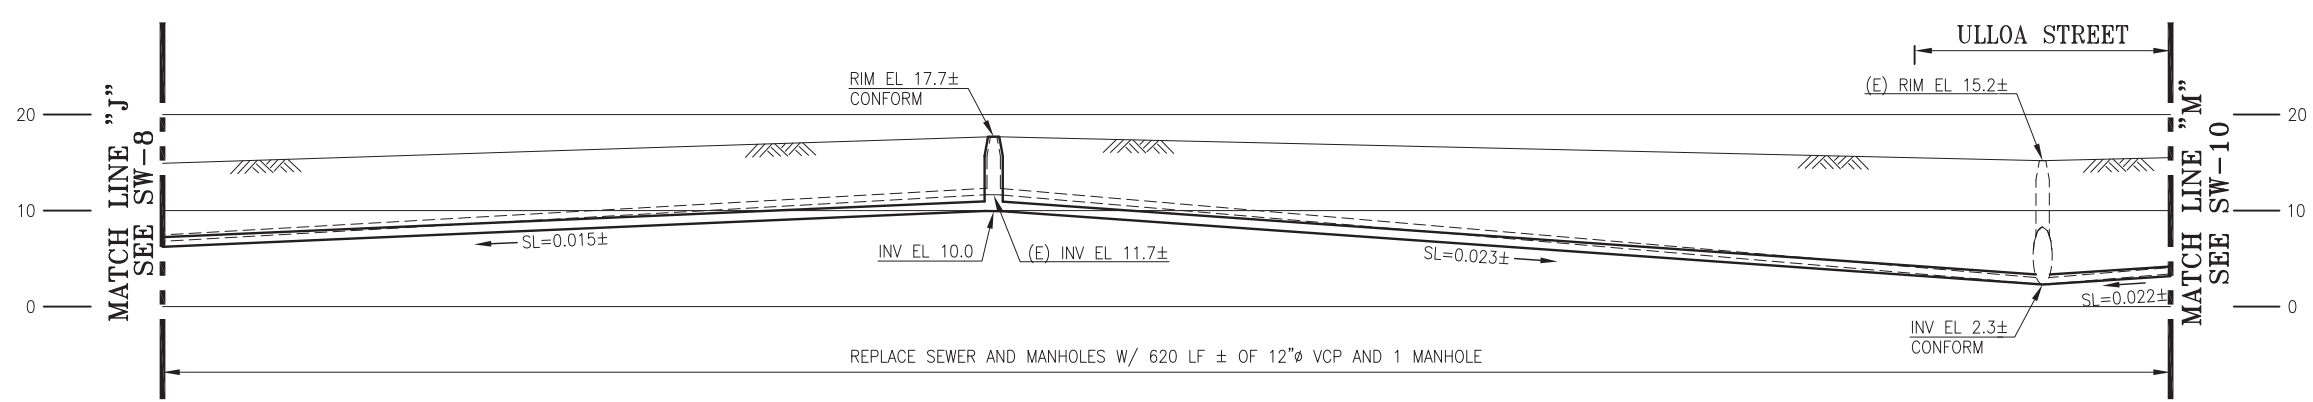



A B C D E F G H I J K L M N O P

1 2 3 4 5 6 7 8 9

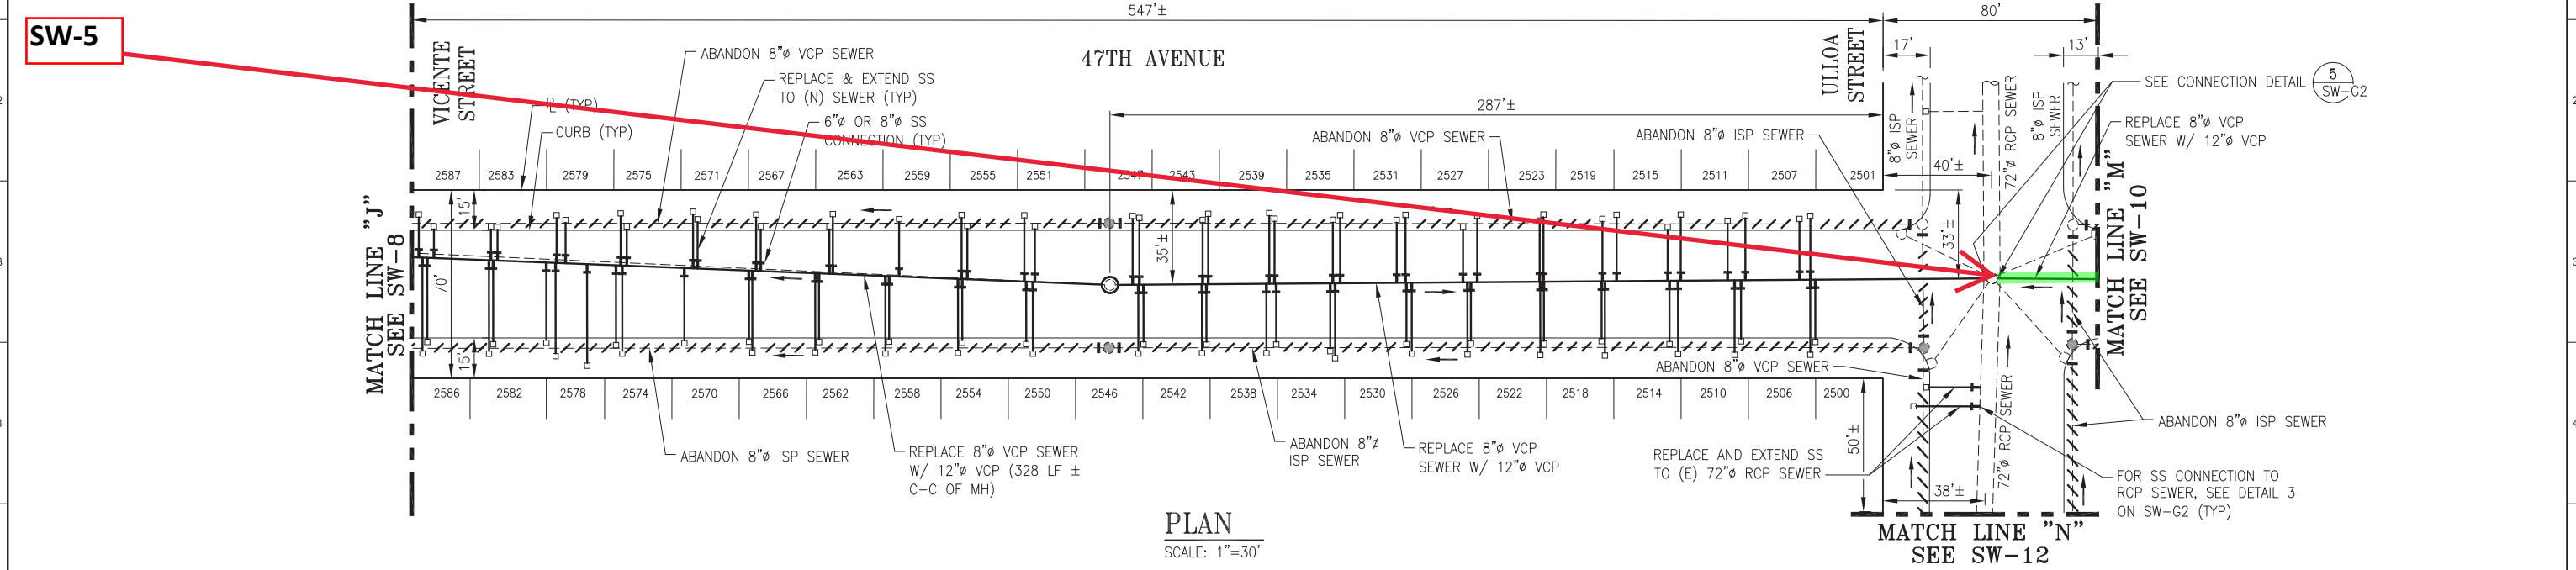

NOTES:

- CONTRACTOR IS TO USE A WYE CONNECTION FOR SIDE SEWER LATERAL LOCATIONS ON THE SAME PROPERTY IF LATERALS ARE TOO CLOSE TO EACH OTHER TO BE REINSTATED SEPARATELY.
- 5 WORKING DAYS PRIOR TO MOBILIZATION FOR SEWER WORK, VERIFY INVERT ELEVATION AT 72" RCP AND 12" VCP SEWER. PROVIDE THE CITY REPRESENTATIVE WITH THE INVERT ELEVATIONS.

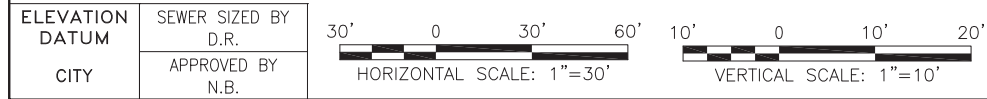

REFERENCE INFORMATION & FILE NO. OF SURVEYS

A-14529-1  
A-7008  
EX-5596  
L-7131  
P-254



CITY AND COUNTY OF SAN FRANCISCO SAN FRANCISCO PUBLIC WORKS BUREAU OF ENGINEERING			
SECTION MANAGER L.WONG	05/12/2022	DRAWN AK/ V.CHEUNG	05/2022
DEPUTY BUREAU MANAGER F.CISNEROS	06/24/2022	DESIGNED H.BAKER	05/2022
ACTING BUREAU MANAGER I.DHAPA	07/07/2022	CHECKED C.LINH	05/2022
NO.	DATE	DESCRIPTION	BY APP'D
REVISIONS			

CONTRACT NO. WW-684 CITY AND COUNTY OF SAN FRANCISCO PUBLIC UTILITIES COMMISSION INFRASTRUCTURE DIVISION ENGINEERING MANAGEMENT BUREAU			
45TH AVE, 46TH AVE, 47TH AVE, VICENTE ST, WAWONA ST, AND SLOAT BLVD SEWER REPLACEMENT			
47TH AVENUE VICENTE STREET TO ULLOA STREET PLAN AND PROFILE			
CHECKED / APPROVED	DRAWN	SCALE	
SECTION MANAGER	DESIGNED	DATE	
APPROVED	APPROVED		
MANAGER, ENGINEERING MANAGEMENT BUREAU		ASSISTANT GENERAL MANAGER WASTE WATER ENTERPRISE	
SHEET 13 OF 44	PLAN NO. SW-9	DRAWING / FILE NO. 121,460	REVISION NO. 0