



SW-342

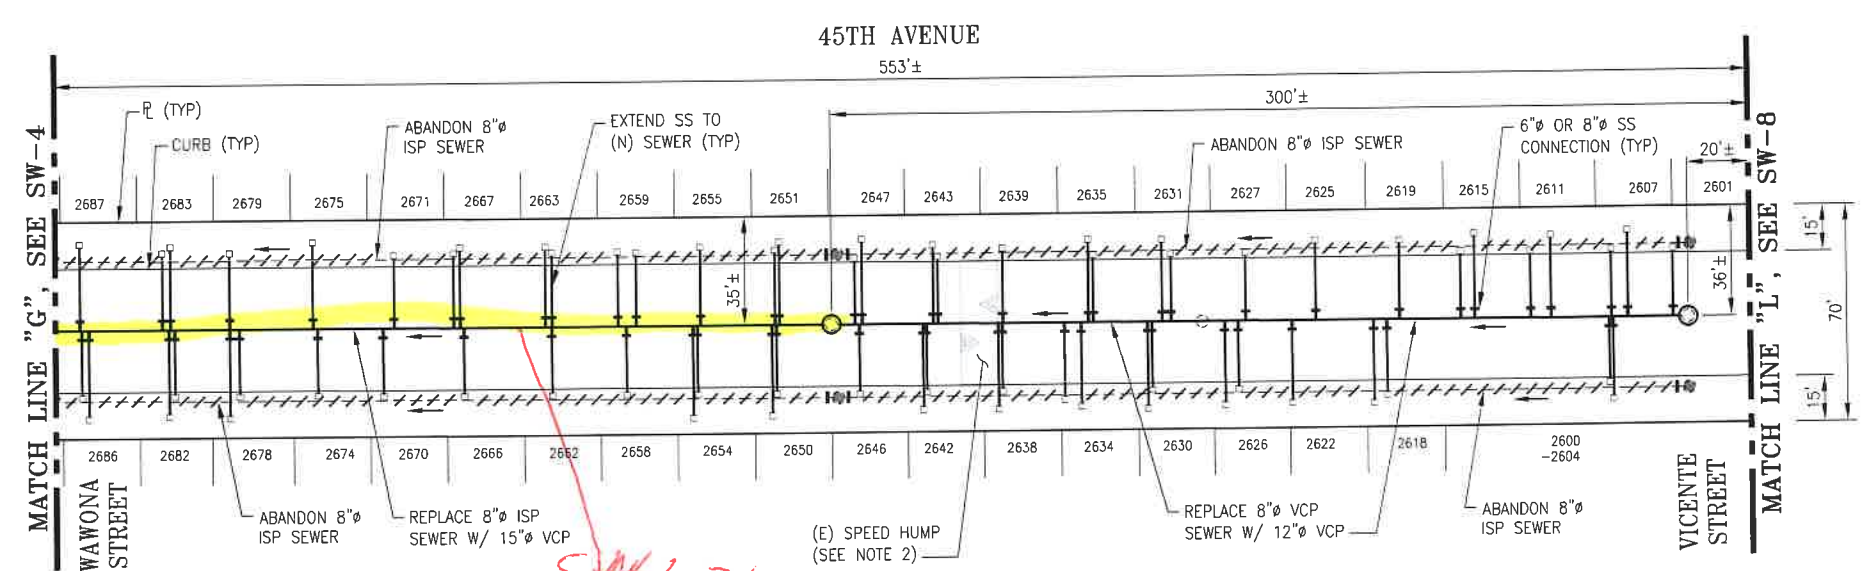

PLAN
SCALE: 1"=30'

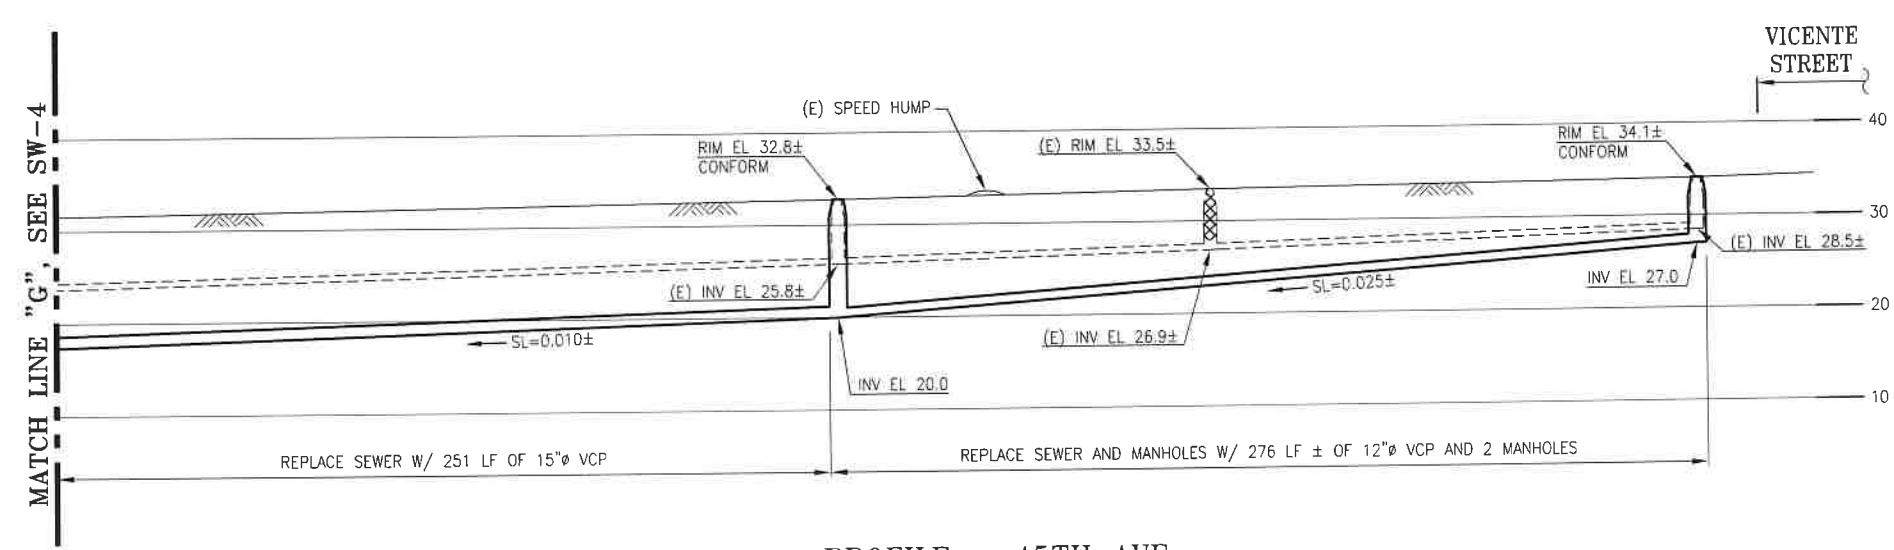

PROFILE - 45TH AVE
SCALE: HORIZ 1"=30'
VERT 1"=10'

NOTES:

1. CONTRACTOR IS TO REMOVE 8" ISP SEWER TO BE ABANDONED IF WORK IS UNABLE TO BE COMPLETED PER ORIGINAL SCOPE.
2. REMOVE/DEMOLISH SPEED HUMP PRIOR TO FINAL ACWS RESTORATION. SEE PR-4 FOR RESTORATION OF SPEED HUMP.
3. CONTRACTOR IS TO USE A WYE CONNECTION FOR SIDE SEWER LATERAL LOCATIONS ON THE SAME PROPERTY IF LATERALS ARE TOO CLOSE TO EACH OTHER TO BE REINSTATED SEPARATELY.

ELEVATION DATUM	SEWER SIZED BY D.R.
CITY	APPROVED BY N.B.

30' 0 30' 60'

10' 0 10' 20'

HORIZONTAL SCALE: 1"=30'

VERTICAL SCALE: 1"=10'

FOR REDUCED PLANS ORIGINAL SCALE IS IN INCHES

REFERENCE INFORMATION & FILE NO. OF SURVEYS
612
A-7008
EX-3180.1
EX-2180.2



CITY AND COUNTY OF SAN FRANCISCO	
SAN FRANCISCO PUBLIC WORKS	
BUREAU OF ENGINEERING	
SECTION MANAGER L. WONG	DATE 05/2022
DEPUTY SECTION MANAGER F. CISNEROS	DATE 05/2022
ACTING SECTION MANAGER J. HAPPA	DATE 05/2022
TRAMP AK/ V. CHEUNG	DATE 05/2022
DESIGNER H. BAKER	DATE 05/2022
CHECKER C. LINH	DATE 05/2022
NO.	DATE
DESCRIPTION	BY
REVISIONS	APPROVED

CONTRACT NO. WW-684			
CITY AND COUNTY OF SAN FRANCISCO			
PUBLIC UTILITIES COMMISSION			
INFRASTRUCTURE DIVISION			
ENGINEERING MANAGEMENT BUREAU			
45TH AVE, 46TH AVE, 47TH AVE, VICENTE ST, WAWONA ST, AND SLOAT BLVD SEWER REPLACEMENT			
46TH AVENUE			
WAWONA STREET TO VICENTE STREET			
PLAN AND PROFILE			
CHECKED / APPROVED	DATE	APPROVED	DATE
SECTION MANAGER	DATE	APPROVED	DATE
MANAGER, ENGINEERING MANAGEMENT BUREAU		ASSISTANT GENERAL MANAGER, WASTE WATER ENTERPRISE	
NO. 11 OF 44	PLAN SW-7	121,458	0

HYD PROJECT NO. 10701